


RECORD DRAWING NOTE:  
 RECORD DRAWING IS DEFINED AS A DRAWING PREPARED FROM INFORMATION SUPPLIED BY THE CLIENT OR OTHER SOURCE. THE CONTRACTOR SHALL BE RESPONSIBLE FOR VERIFYING THE ACCURACY OF THE INFORMATION PROVIDED BY THIS PLAN. THE CONTRACTOR SHALL LOCATE ALL UTILITIES IN THE FIELD AND SHALL BE RESPONSIBLE FOR THE LOCATION SERVICES TO CORRECT THE ACCURACY OF THE INFORMATION PROVIDED BY THIS PLAN.

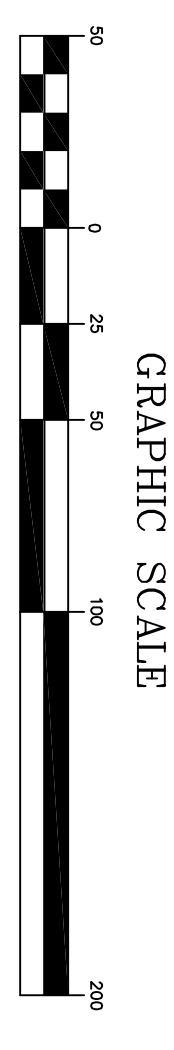


PROJECT - LIBERTY HIGH SCHOOL ALTERATIONS & ADDITIONS  
 1115 LINDEN ST., BETHLEHEM, PA  
 OWNER - BETHLEHEM AREA SCHOOL DISTRICT (BASD)  
 1516 SYCAMORE ST., BETHLEHEM, PA 18017

AB.02  
**RECORD DRAWING**  
**SITE UTILITY PLAN**

PROJECT NO. 1348.14 DATE: 1-24-11  
 CAD FILE NO. REVISED PER CITY ENGINEER REVIEW 3-21-11

DRAWINGS NOT VALID UNLESS PROFESSIONAL SEAL IS AFFIXED.  
 COPYRIGHT 2011 SFSPW

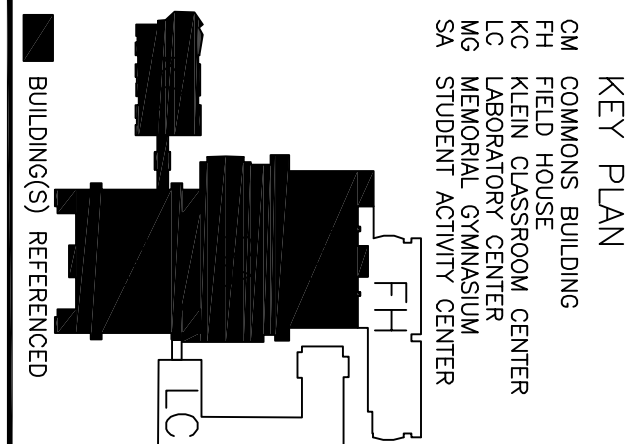

CONSULTANT  
 COWAN ASSOCIATES, INC.  
 ENGINEERS, GEODETISTS, SURVEYORS  
 LANDSCAPE ARCHITECTS  
 1000 N. WILSON, P.O. BOX 500  
 BETHLEHEM, PA 18018-0500  
 TEL: (610) 865-3236

KEY PLAN  
 COMMONS BUILDING  
 STUDENT ACTIVITY CENTER  
 LAB CENTER  
 MEMORIAL GYMNASIUM  
 CLASSROOM BUILDING  
 STUDENT ACTIVITY CENTER

**SPILLMAN FARMER**  
 architects

ONE BETHLEHEM PLAZA, SUITE 1000, BETHLEHEM, PA 18018-5765  
 TELEPHONE 610.865.2621 FACSIMILE 610.865.3236 WWW.SPILLMANFARMER.COM SPILLMAN@SPILLMANFARMER.COM